



REV 1	Tender Issue	10.06.20 (HB)
REV 1	Minor amendments to furniture layout	29.06.21 (HB)
REV 2	Various amendments as annotated	03.07.21 (HB)
REV 3	Changed to Status: Construction	22.07.21 (HB)
REV 4	Change to wall position / locker configuration / reception	08.09.21 (HB)
REV 5	As Built	18.10.21 (HB)

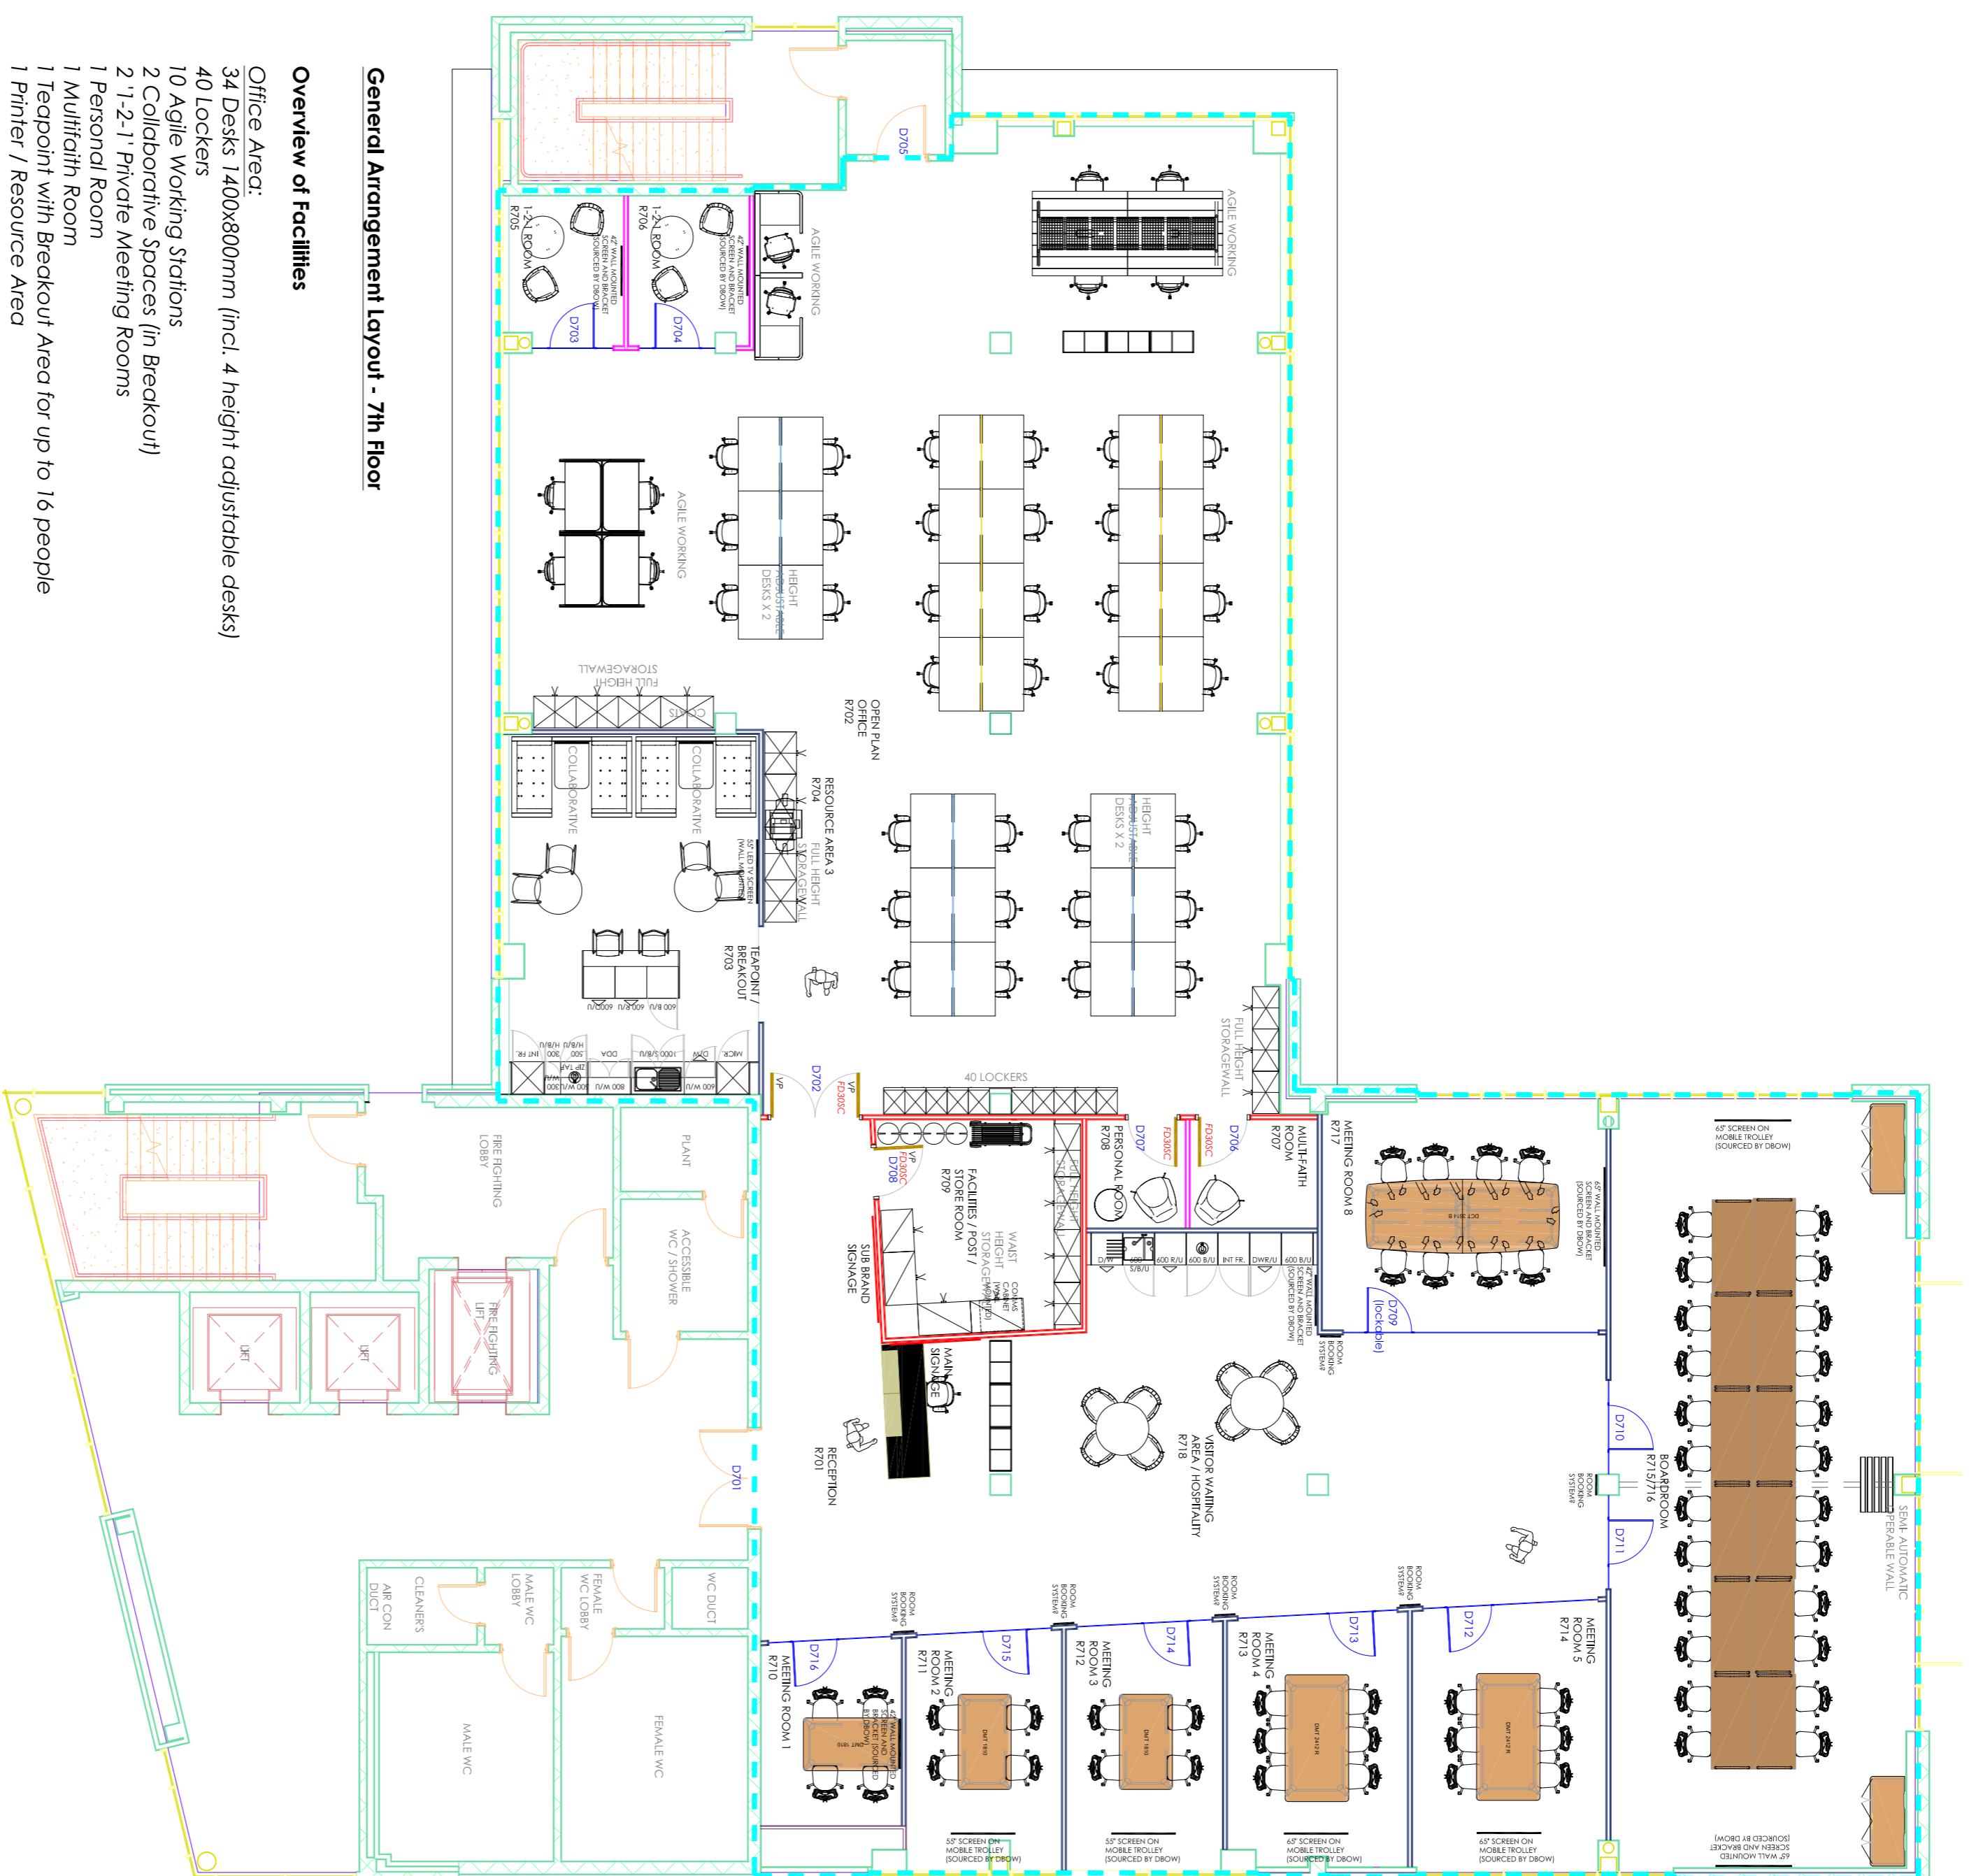


**General Arrangement Layout - 7th Floor**

**Overview of Facilities**

- Office Area:**  
 34 Desks (400x800mm (incl. 4 height adjustable desks))  
 40 Lockers  
 10 Agile Working Stations  
 2 Collaborative Spaces (In Breakout)  
 2 1-2-1 Private Meeting Rooms  
 1 Personal Room  
 1 Multifunction Room  
 1 Teapoint with Breakout Area for up to 16 people  
 1 Printer / Resource Area
- Visitor Space:**  
 1 Reception Desk  
 Visitor Refreshment Area for up to 8  
 7/8 Meeting Rooms (varying sizes)  
 1 Facilities / Storeroom

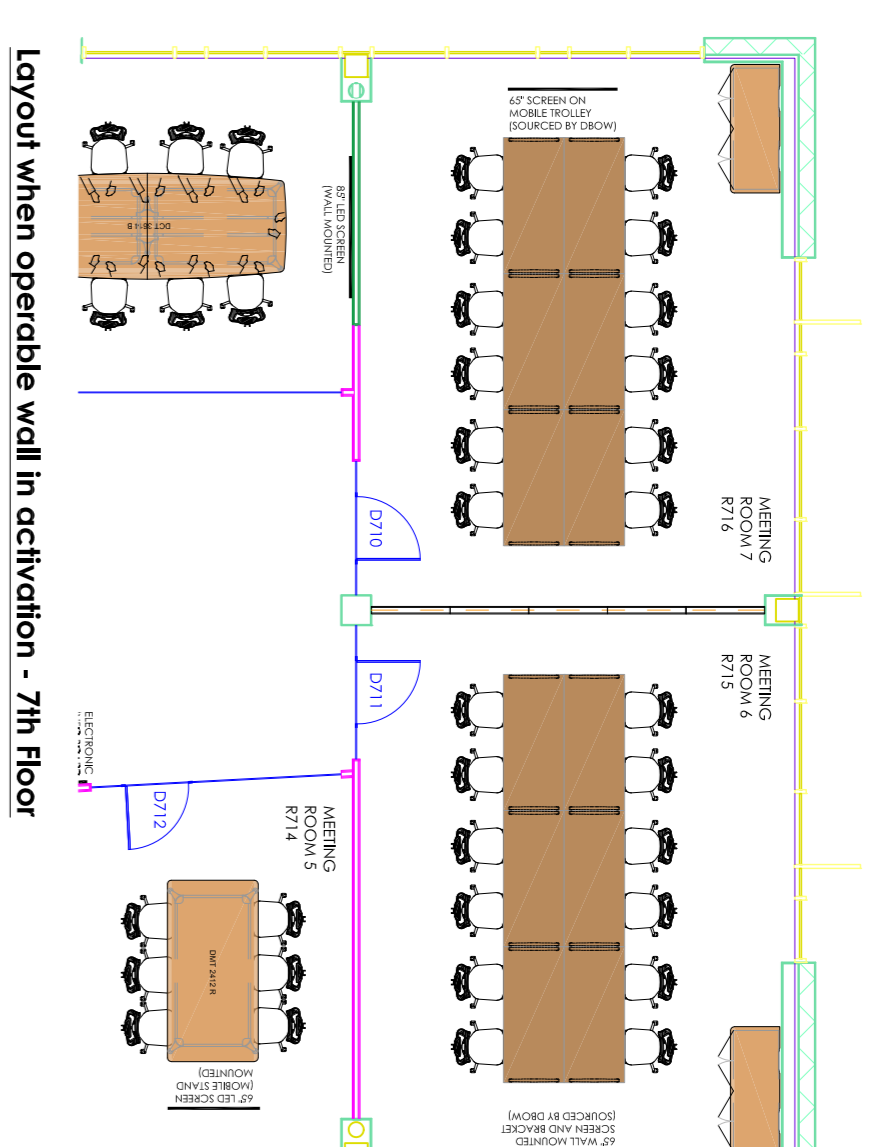

Layout when operable wall in activation - 7th Floor

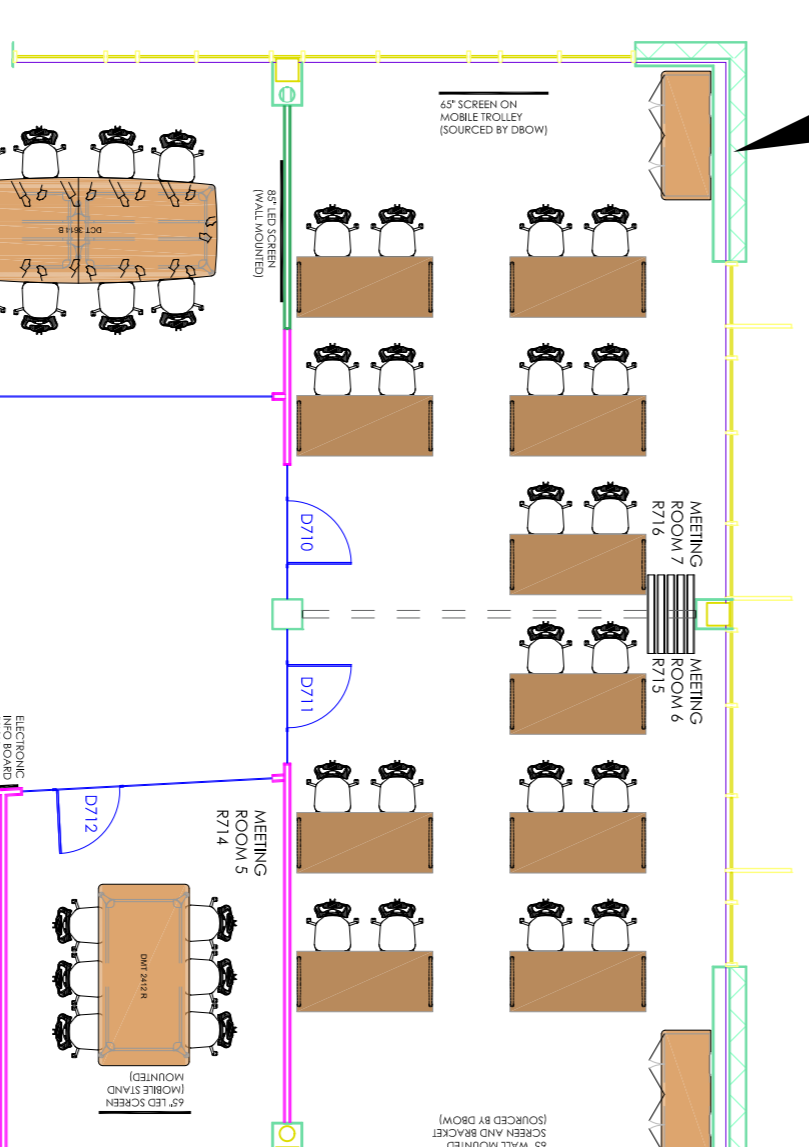

Layout for training purposes - 7th Floor

--- denotes extent of works

# PARAMOUNT

## OPTIMISING SPACE

**Client:** Development Bank of Wales  
 1 Capital Quarter, Tyndall Street, Cardiff, CF10 4BQ  
**Title:** General Arr. Layout - 7th Floor  
**Scale:** 1:1000@A1  
**Date:** 10th June 2020  
**Drawing No:** 18492-07-010004  
**Revision:** 5  
**Drawn by:** HB  
**Checked by:** -  
**Drawing Status:** **As Built**

All dimensions are in millimetres unless otherwise stated

