


- Finishes Key:**
-  Vinyl tile flooring
  -  Ref. Amtico Access Ceramic Desk
  -  Ref. Amtico Spacia New England Oak

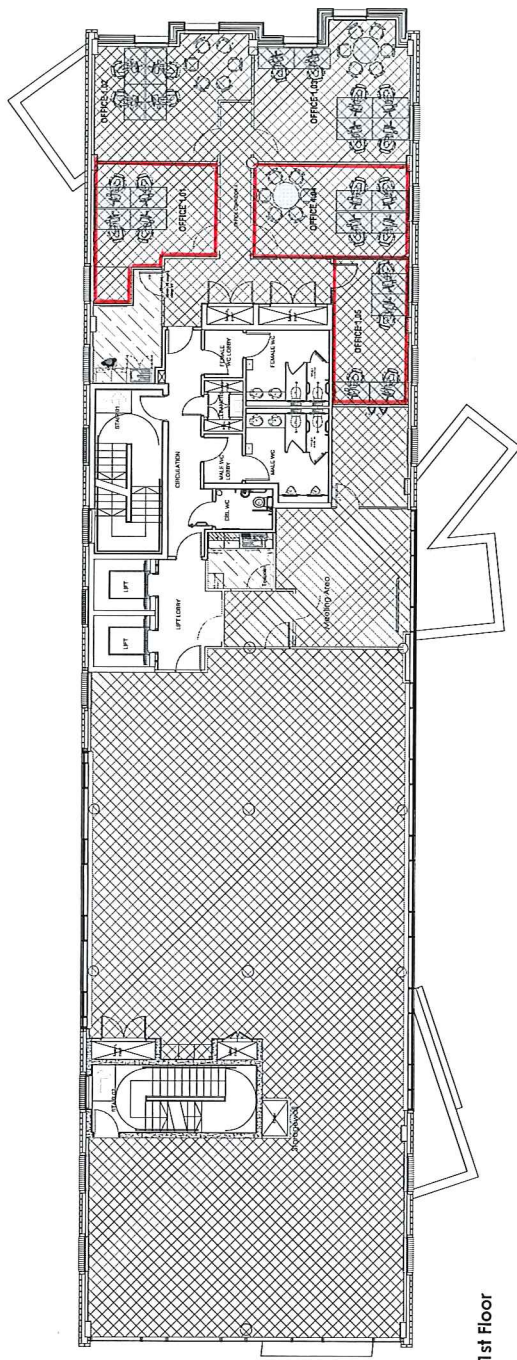

1st Floor

# PARAMOUNT OPTIMISING SPACE

Client: Welsh Government  
 Site: Gwynedd, Porth Iago, Cardiff Bay

Title: A1 Built 1st Floor - General Arrangement & Finishes  
 Date: 11/09/2014  
 Drawing No: 11/09/2014  
 Revision: 1.00  
 Designer: JOW  
 Checked by: JOW  
 Drawing Status: As Built

© Paramount Space Ltd. All Rights Reserved. 2014  
 www.paramountspace.com  
 Contact: Simon Hines, Head Office, 25 Abchurch Lane, London EC4A 3DF  
 Contact: 49 North Street, Gloucester, Gloucestershire GL1 2NR  
 Complete the Building. The Property of Paramount Space Ltd.

